


此款产品使用簿偏光片

NOTES:

1. DISPLAY TYPE: 2.0", TFT-LCD, 65K/262K COLORS
2. DISPLAY MODE: NORMALLY black
3. VIEWING DIRECTION: Free viewing angle
4. DRIVER IC: S17775R (COG)
5. VCI/VCCIO: 3.3V(TYP)
6. OPERATING TEMP: -20°C TO 70°C  
STORAGE TEMP: -30°C TO 80°C
7. BACK LIGHT: LED WHITE, 3 LED, 45mA, 3.2±0.3V
8. RoHS COMPLIANT.

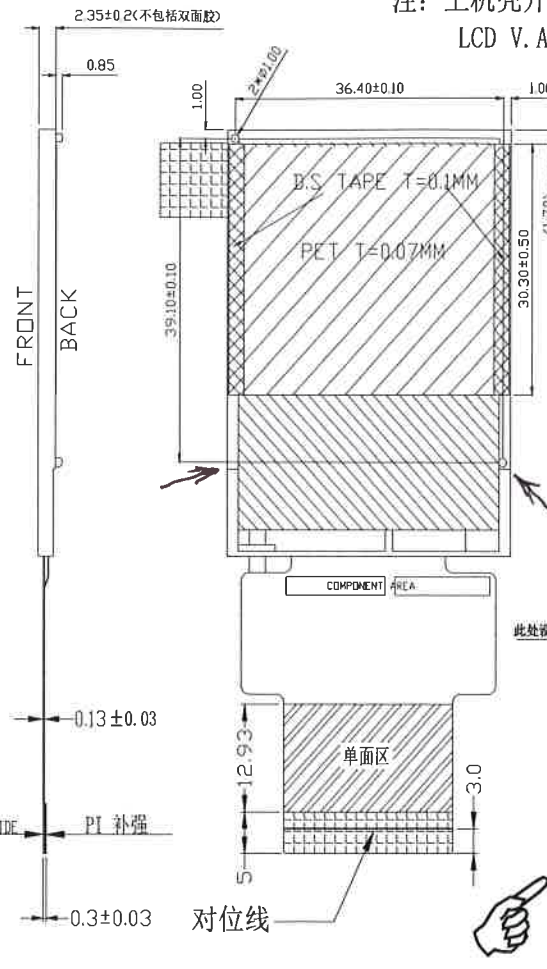


注: 上机壳开窗须小于LCD/CF 0.3mm以上,  
LCD V.A为镜片建议开窗尺寸!

IM3	IM2	IM0	80 Interface type	DB Pin in use
0	0	1	DBI Tvb_ 8-bit interface	DB17-DB10
0	0	0	DBI Tvb_ 16-bit interface	DB17-DB10 DB8-DB1
1	0	1	DBI Tvb_ 9-bit interface	DB17-DB9
1	0	0	DBI Tvb_ 18-bit interface	DB17-DB0
0	1	0	3-Wire 9 BIT data serial interface	SDI SCL CS
0	1	1	4-Wire 8 BIT data serial interface	SDI SCL CS RS

NOTE:

1. If not use PIN, fix to the GND ,IOVCC or NC.
2. If use RGB mode must select serial interface

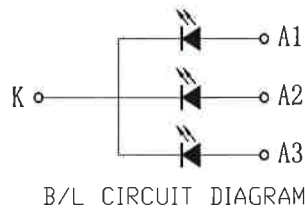

Pin	Name
1	GND
2	VCC
3	VCCIO
4	RS
5	CS
6	VSYNC
7	HSYNC
8	DOTCLK
9	DEN
10	RESET
11	SDI
12	RD
13	WR
14	DB17
15	DB16
16	DB15
17	DB14
18	DB13
19	DB12
20	DB11
21	DB10
22	DB9
23	DB8
24	DB7
25	DB6
26	DB5
27	DB4
28	DB3
29	DB2
30	DB1
31	DB0
32	IM3
33	IM2
34	IM0
35	SDO
36	GND
37	LE.DK
38	LE.D1A
39	LE.D2A
40	LE.D3A
41	YU(NC)
42	X(RNC)
43	Y(DNC)
44	XL(NC)
45	GND

Rev	Revision content description	Date
A	FIRST	2018/03/23

深圳市柯达科电子科技有限公司  
SHENZHEN STARTEK ELECTRONICS CO.,LTD

TOLERANCE(公差)	DRAWING NAME	KD020C-2A-XXX	
OTHERWISE SPECIFIED	PARTS NO.	Drawn	Unit
X.X±0.3			
X.XX±0.2		Checked	mm
Scale 1:1		Approve	Page 1/1